

10TH FLOOR

NEW FLOOR

22,794 RSF

LEASING INFORMATION

DOUG MUELLER

202.719.5594

doug.mueller@am.jll.com

KRISTEN MATHIS

202.719.5623

kristen.mathis@am.jll.com

EMILY BALKAM


202.719.6902

emily.balkam@am.jll.com

Columbia
Property Trust



80M
STREET

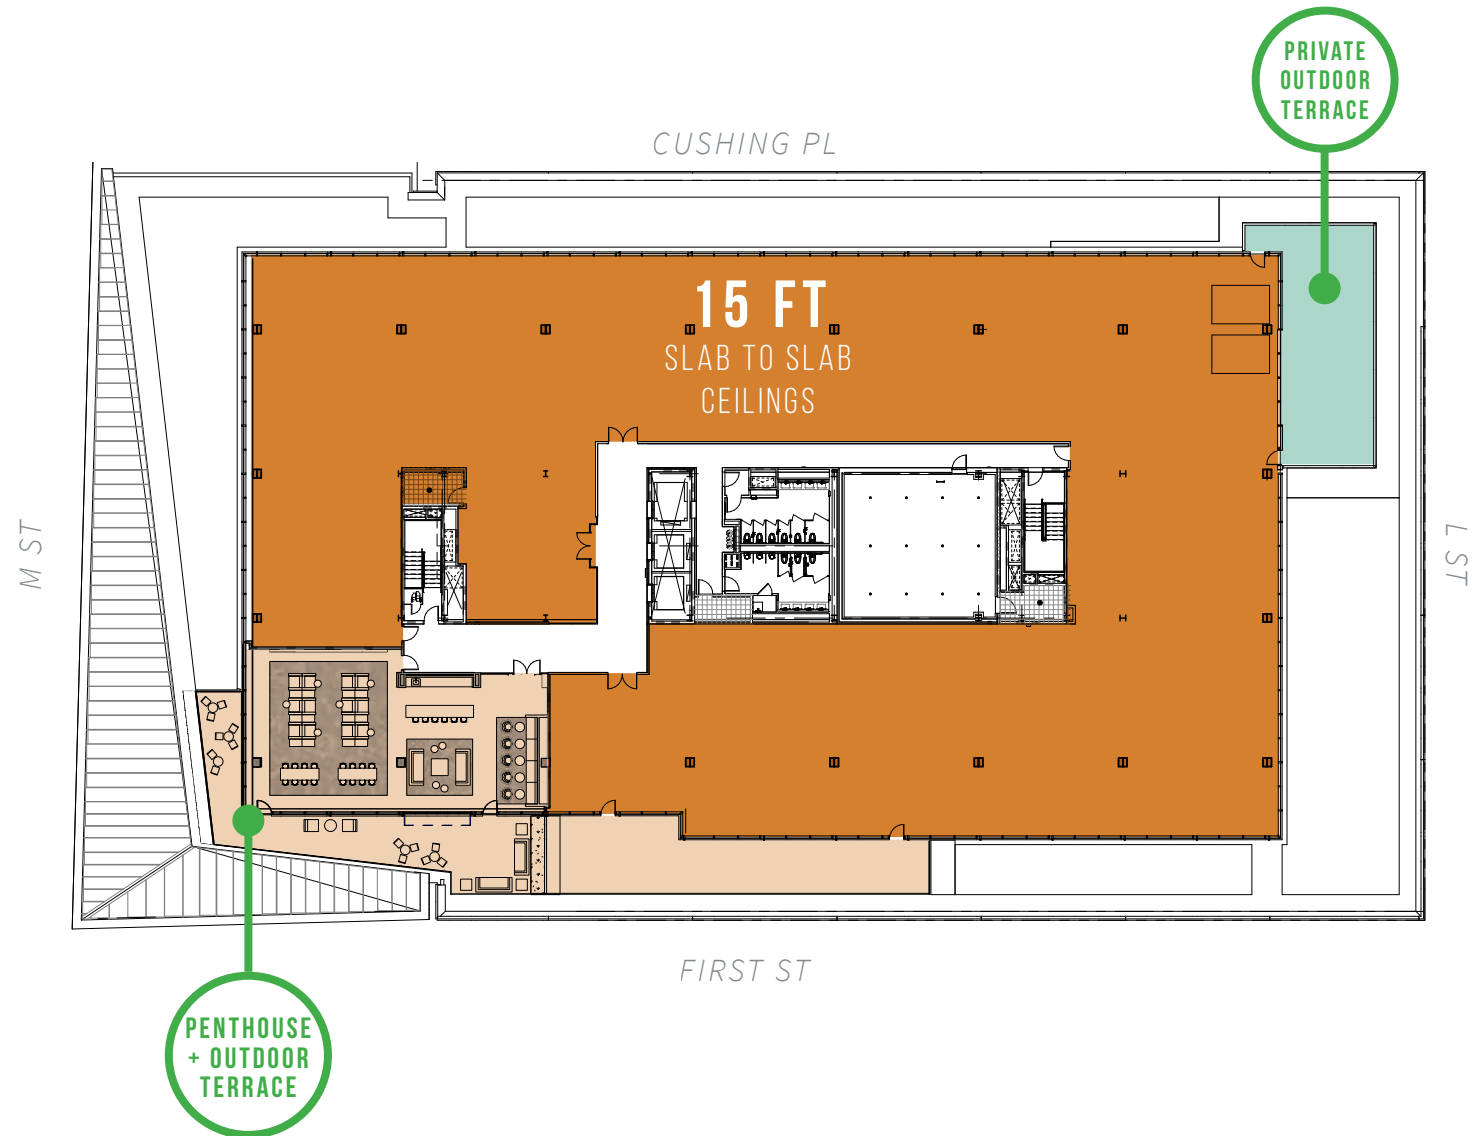

9TH FLOOR

NEW FLOOR

23,882 RSF

LEASING INFORMATION

DOUG MUELLER

202.719.5594

doug.mueller@am.jll.com

KRISTEN MATHIS

202.719.5623

kristen.mathis@am.jll.com

EMILY BALKAM

202.719.6902

emily.balkam@am.jll.com



80M
S T R E E T



7TH FLOOR

FULL FLOOR

42,341 RSF

LEASING INFORMATION

DOUG MUELLER

202.719.5594

doug.mueller@am.jll.com

KRISTEN MATHIS

202.719.5623

kristen.mathis@am.jll.com


EMILY BALKAM

202.719.6902

emily.balkam@am.jll.com



80M
S T R E E T

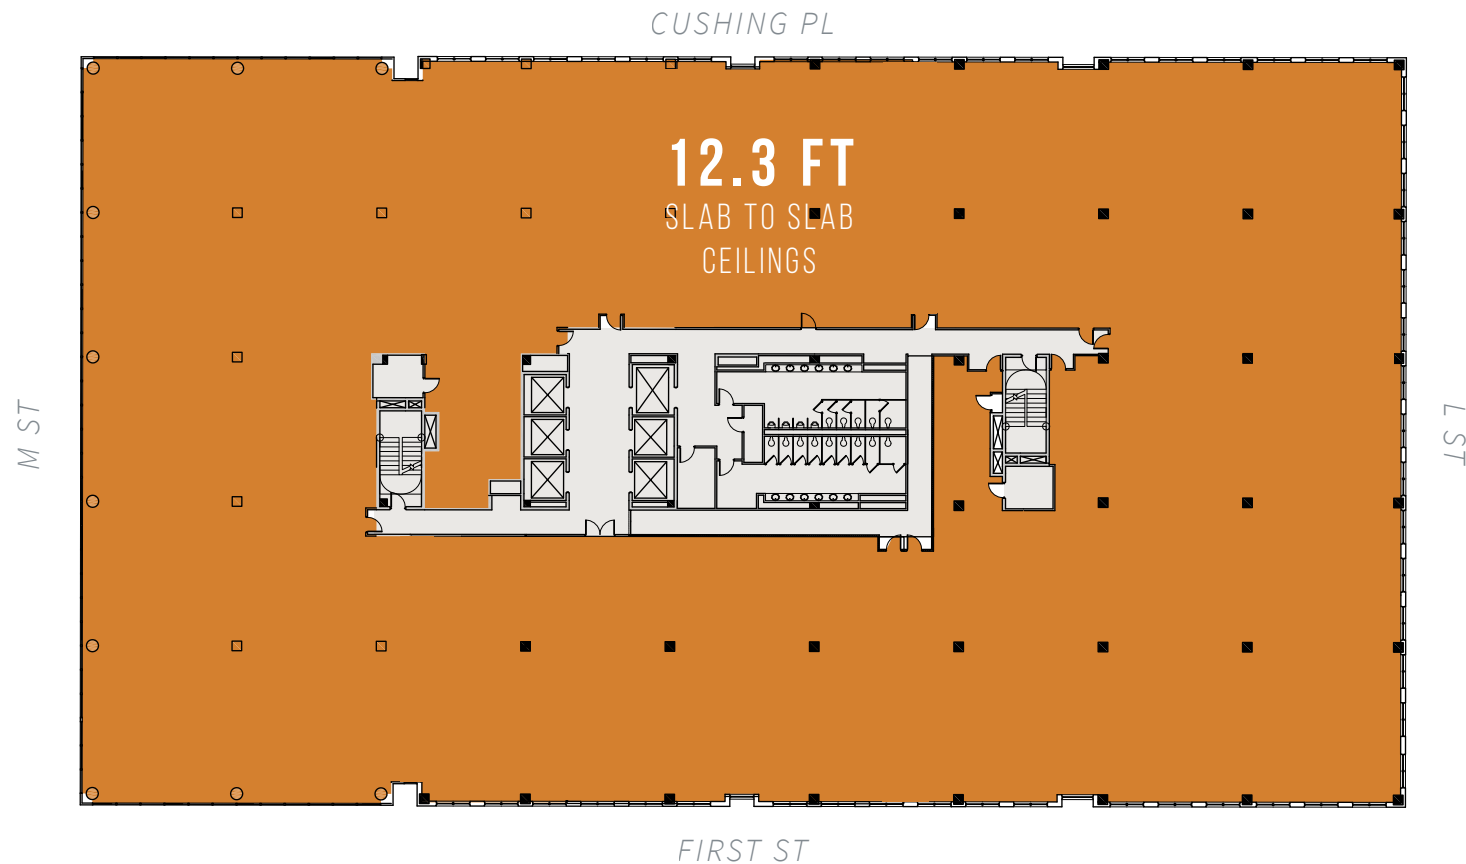

6TH FLOOR

AS-BUILT PLAN

26,803 RSF

80M
STREET

LEASING INFORMATION

DOUG MUELLER

202.719.5594

doug.mueller@am.jll.com

KRISTEN MATHIS

202.719.5623

kristen.mathis@am.jll.com

EMILY BALKAM

202.719.6902

emily.balkam@am.jll.com



CUSHING PL



FIRST ST

5TH FLOOR

AS-BUILT PLAN

44,208 RSF

LEASING INFORMATION

DOUG MUELLER

202.719.5594

doug.mueller@am.jll.com

KRISTEN MATHIS

202.719.5623

kristen.mathis@am.jll.com


EMILY BALKAM

202.719.6902

emily.balkam@am.jll.com



80M
STREET

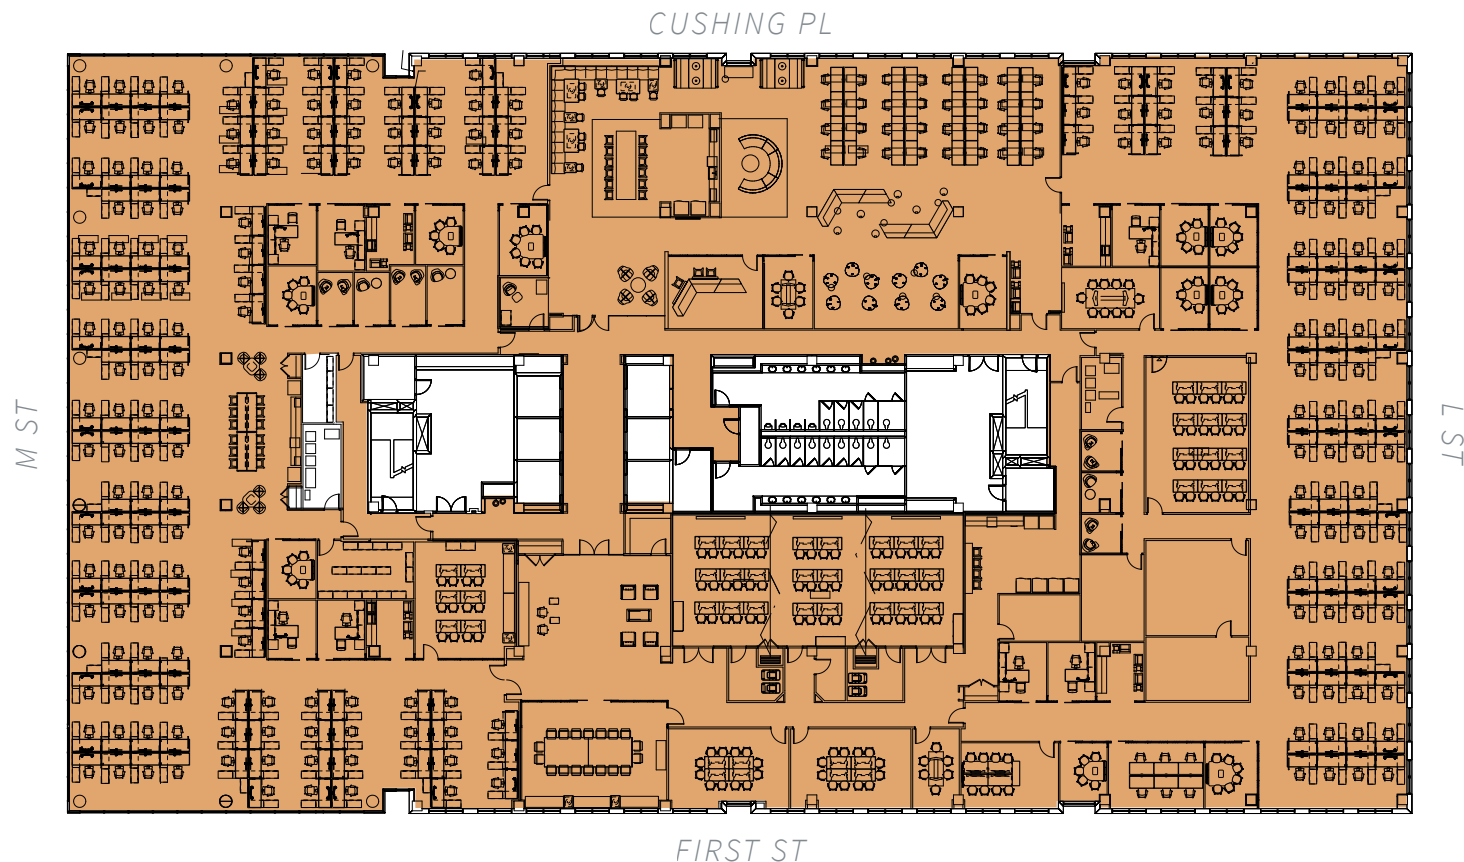

4TH FLOOR

AS-BUILT PLAN

20,915 RSF

80M
STREET

LEASING INFORMATION

DOUG MUELLER

202.719.5594

doug.mueller@am.jll.com

KRISTEN MATHIS

202.719.5623

kristen.mathis@am.jll.com

EMILY BALKAM

202.719.6902

emily.balkam@am.jll.com



3RD FLOOR

AS-BUILT PLAN

12,508 RSF

80M
STREET

LEASING INFORMATION

DOUG MUELLER

202.719.5594

doug.mueller@am.jll.com

KRISTEN MATHIS

202.719.5623


kristen.mathis@am.jll.com

EMILY BALKAM

202.719.6902

emily.balkam@am.jll.com

Columbia
Property Trust

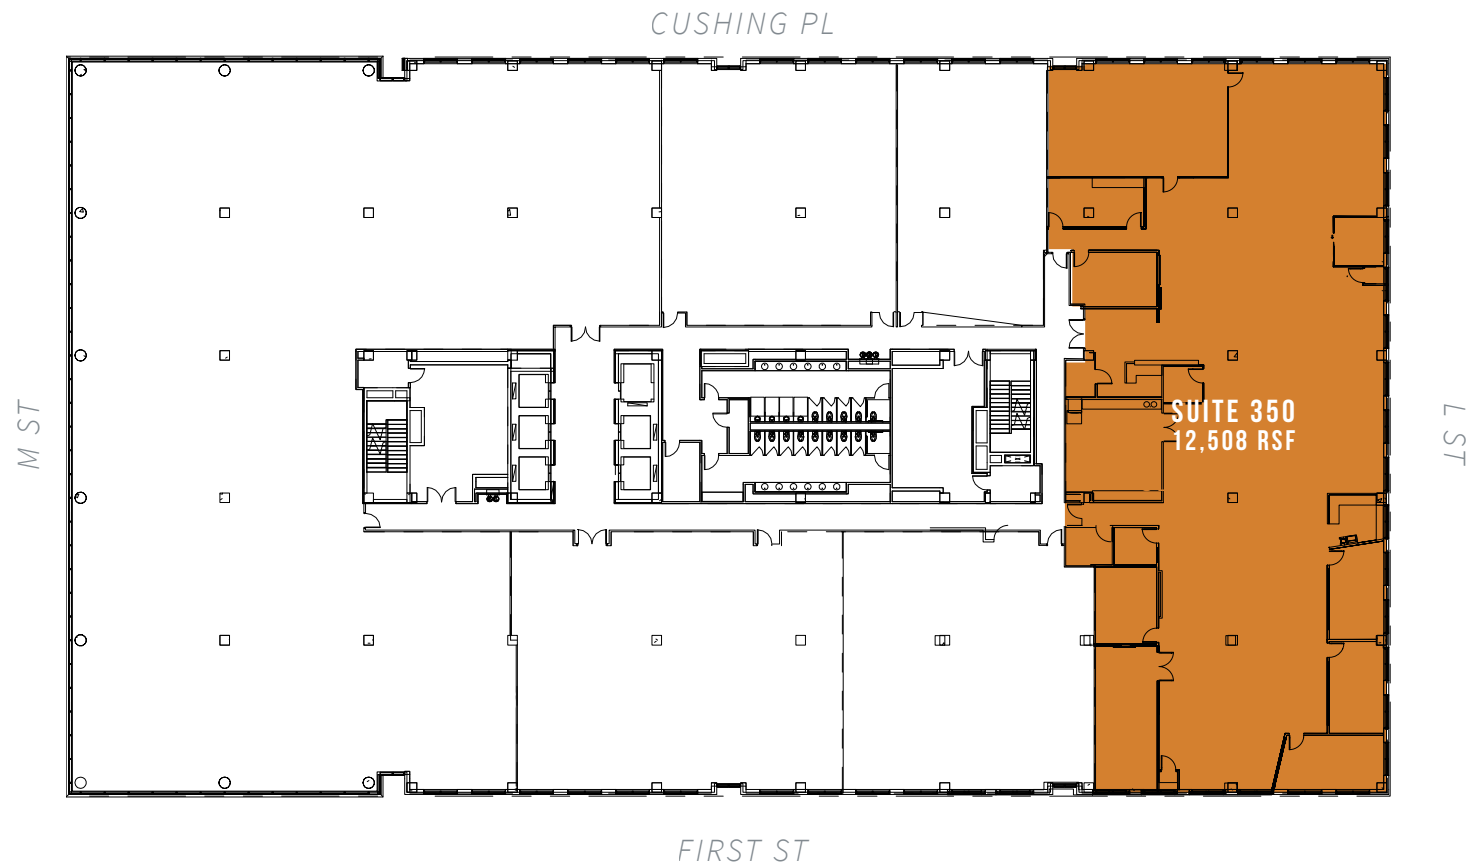

1ST FLOOR

GROUND LEVEL

5,391 RSF

LEASING INFORMATION

DOUG MUELLER

202.719.5594

doug.mueller@am.jll.com

KRISTEN MATHIS

202.719.5623

kristen.mathis@am.jll.com

EMILY BALKAM

202.719.6902

emily.balkam@am.jll.com



80M
S T R E E T

